

28

מדינת ישראל

משרד ראש הממשלה

ארכיון המדינה

לרשם להסדר תעודות - להגשת תביעות

81
ליז, סג

Valuation of Land - Camps -
Tulkarm, Nathania, Mt. Kan'an.

~~1945~~

מכיל מס' _____
תיק מס' (682'447) 1/11/74

מדינת ישראל גנזך המדינה	
	
שם: Mt.Kan'an Camp No.287-Billet A	
מ - 5030/8	מזהה פיזי:
22.1/17 - 186	מזהה לוגי:
02-108-11-03-09	כתובת:
31/08/2004	

מחלקה לרשם וסדר תעודות - להגשת תביעות

Lv/1/7(289)

Main file Lv/1/7

VALUATION OF LAND

TULKARM CAMP 23.

Lv/1/7(289)

LV/1/7(288)

Main file LV/1/7

VALUATION OF LAND

NATHANIA CAMP 1-4.

LV/1/7(288)

VALUATION OF LAND

MT. KAN'AN CAMP No 287

BILLET AREA

GALILEE

S E C R E T

Mt. Keneen Camp No. 287.
Billet No. 683.

Our Spot Valuation of the site (excluding buildings and trees) shown on the plan enclosed with A.D. Hirings letter No. 168/Hgs. dated 14.9.45, at the time of occupation, that is 1.1.38 (no account being taken of any appreciation in the value thereof due to the emergency) is *see serial file LV/S/3*

Dated the 1st of February, 1946.

A.G.
A.G. KHOURI
ASST. LAND VALUER

M.L.
M. LEVIN
ASST. LAND VALUER

RC.

See LV/1/7 file 118

C O P Y

SUBJECT:- 'Spot' Valuations.

HIRINGS SERVICE
HQ PALESTINE
Tel. 4651-Ext. 190
168/Hga,
14 Sep 45.

Director of Land Settlement,
Jerusalem.

1. Will you please supply 'spot' valuations of the following sites:-

Section 3. Not urgent as Installation Valuation Returns have already been sent to GHQ. Land values are required in confirmation of estimates given by this Service in an emergency. (Please see folio 100 of File No. LV/1(7) General).

<u>Hg. No.</u>	<u>WD Inst. No.</u>	<u>Plan No.</u>	<u>Name of Site</u>	<u>File No.</u>
1595/1	1026/34	H/59	R.A.F. Officers Acc. French Camel	LV/1/7 (253)
1596/1	" /35	H/60	R.A.F. Sgts. Acc. French Camel	" (254)
1274/34	1018/264	H/217	S/L No. 10	" (255)
1274/14	1019/18	H/171	El-Burj - S/L	" (256)
1274/11	" /101248	H/208	S/L No. 6 Et-Tira	" (257)
1519 (billet)	" /273	H/221	Camouflage Workshop	" (258)
1274/9	1019/20	H/219	Et Hawassat S/L	" (259)
2091/1	1026/30	G/292	R.A.F. Water Pump Gaza	" (260)
1274/19	1018/100	H/216	S/L No. 19 Khirbat Ed Daun	" (261)
1274/44	" /280	H/222/1	S/L No. 11 Kefar Hassaidim	" (262)
1274/29	1018/281	H/223	S/L No. 16	" (263)
1014/1	" /156	H/17	Mt. Canaan Camp	" (264)
1462/1	" /260	H/111	Ar Rama R.E. Yard	" (265)
1274/2	" /250	H/180	S/L No. 2 (Old)	" (266)
2124 /142	1026/39	G/330	Bureir Bombing Range	" (267)
2253/1	1018/247	H/92	Emergency Shelter	" (268)
1409/1	" /217	H/24	Es Zib Camp 258	" (269)
1274/26	" /249	H/143	S/L No. 11 (Old)	" (270)
1445/4	1018/181	H/100	Metullah Camp 291	" (272)
1559/1	" /276	H/55	S/L Wing AA & CD Park	" (272)
984/5	" /271	H/25	H.A.A. Site 'S' Qiryat Motzkin	" (273)
517/1	" /274	H/69	A.M.W.D. Yard Kiryat Eliahu	" (274)
1367/1-2	" /290	H/48/1-2	RASC Car Park	" (275)
2299/1-2	" /285	H/144/1-2	HAA Site 'S'	" (276)
683 (billet)	" /261	H/109	Mt. Canaan Billet Area (Camp 287)	" (277)
1591/1	" /277	H/66	Camp 290 Kiryat Samuel	" (278)
2125/142	1026/39	G/331	Kaukaba Bombing Range	" (279)
195 (billet)	1018/299	JH/104	Gelat House	" (280)
1274/21	" /278	H/220	S/L No. 15 Shafa 'Amr Road	" (281)
1273/17	" /270	H/224	L.A.A. Site "C" 15 Ir Ganim	" (282)
1494/1	1019/24	H/117	F.O.P. Acre	" (283)
1274/6	1018/255	H/215	S/L Nahardhof	" (284)
1274/33	" /240	H/106	S/L No. 13 (Old Qiryat Eliahu)	" (285)
1273/4	" /269	H/156	L.A.A. Site 'C' 1	" (244)
1274/30	" /292	H/113	S/L No. 2 Kiryat Eliahu	" (230)


(Sgd.) ϕ
for Lt. Colonel
A. D. Hirings.

DISTRICT : GALILEE

VILLAGE : DHAHIRIYA EL FAUQA

LOCALITY: MT. KAN'AN

BLOCK : UNSETTLED

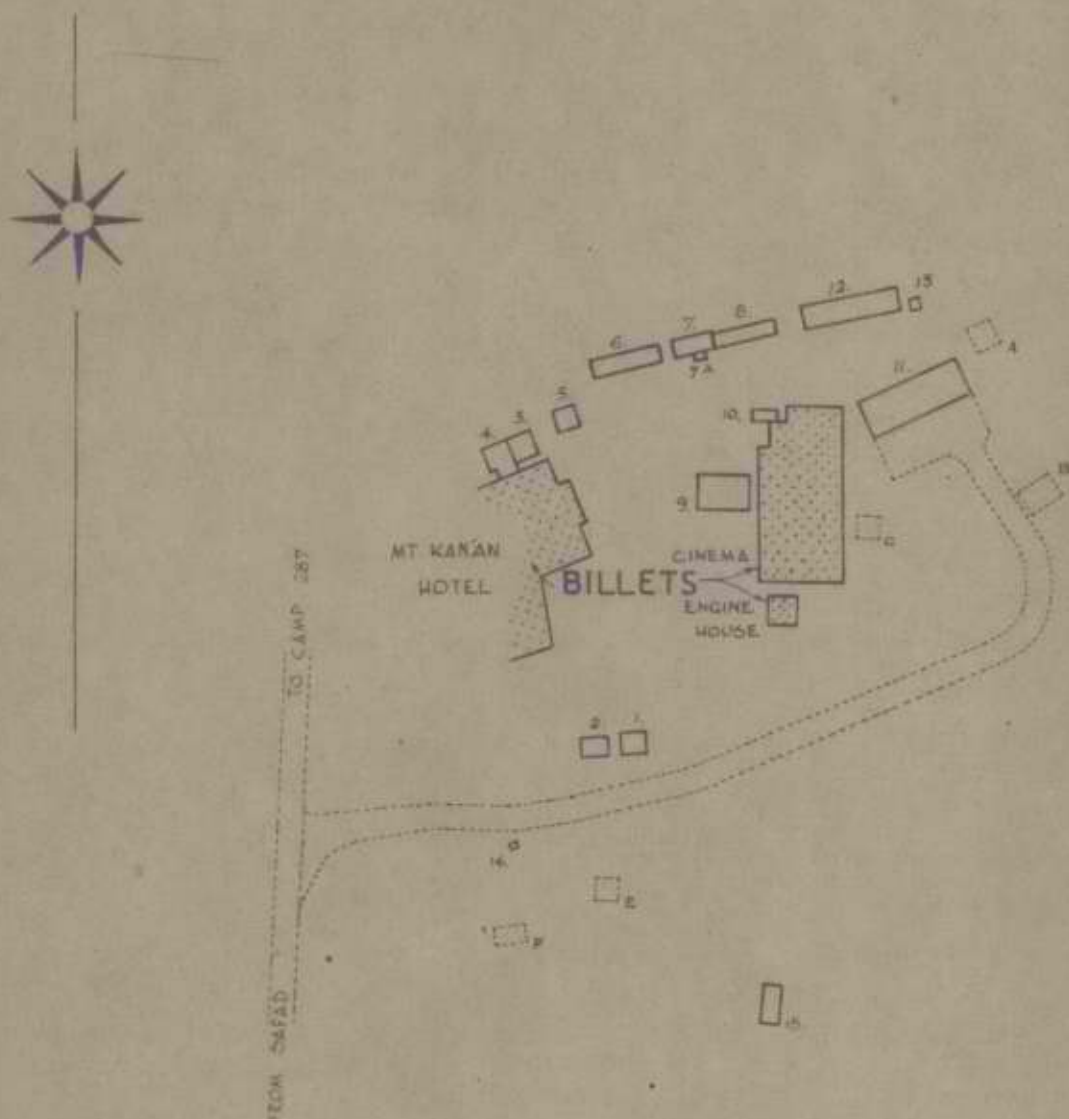


LEGEND:

- Timber or C.G.I. on timber frame
- Concrete slab
- Asphalted road & hardstanding
- Building number



LOCATION PLAN
SCALE 1:100,000

SCALE 1:1250

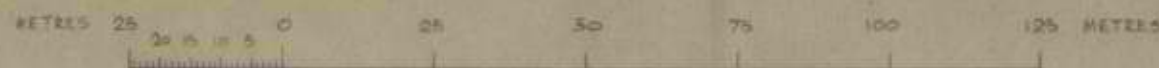

	HIRING PLAN	W. D. INSTALL.	MT. KAN'AN CAMP 287 BILLET AREA	FILE No.	OCCUPIED ON	SURVEYED ON	HIRING No.	SURV. SER. No.
SURVEYED BY	ASKINAZY	ASKINAZY		PAL 1018/261/	1.1.38	7.5.45	683 BILLET	N/109
DRAWN BY	<i>Askazy</i> 2.8.45	<i>Askazy</i> 2.8.45						
CHECKED BY	<i>Ketty</i> 2.8.45	<i>Ketty</i> 2.8.45						

1A

LV/1/7(289).

DEPARTMENT OF LAND SETTLEMENT,
JERUSALEM.

S E C R E T

Camp No.23, Tulkarm,
Hirings Nos.1609/1 and2

My Spot Valuation of the site (partly a State Domain)(excluding buildings and trees) shown on the plan enclosed with A.D. Hirings letter No.168/Hgs. dated 14.9.45 comprising an area of 2312.103 dunums excluding roads, at the times of occupation, that is 1.2.42 and 30.10.42 (no account being taken of any appreciation in the value thereof due to the emergency) is *see secret file LV/5/3*

Dated the 18th of September, 1945.

A.G.
A.G. KHOURI
ASST.LAND VALUER

RC.

C O P Y

SUBJECT:- 'Spot' Valuations.

HIRINGS SERVICE
HQ PALESTINE
Tel. 4651-Ext. 190
168/Hgs.
14 Sep 45.

Director of Land Settlement,
Jerusalem.

1. Will you please supply 'spot' valuations of the following sites:-

Plans are sent herewith.

Section 1. Very urgently required as Installation Valuation Returns are to be submitted during September.

<u>Hg.No.</u>	<u>WD Inst.No.</u>	<u>Plan No.</u>	<u>Name of Site</u>	<u>File No.</u>
504/1	1019/5	H/172	Haifa Harbour Estate	LV/1/7(217)
1528/1	1018/272	H/64	H.A.A. Site 'L', Neuhardhof	LV/1/7(231)
1598/1	" /279	H/96	H.A.A. Site 'Z', Khirbet Damun	LV/1/7(232)
1274/5	1019/16	H/212/1	S/L Motzkin 'B'	LV/1/7(233)
1481/1	1018/183	N/93	Kefar Inan Camp	LV/1/7(234)
1564/1-2	" /87	H/62	Vehicle Park Misliya	LV/1/7(235)
1274/38	1019/23	H/145	S/L No.21 French Carmel	LV/1/7(236)
1157/1	1018/154	L/35	Bashit Camp	LV/1/7(237)


P.S. Ref. your LV/1(7) of 3 Sep 45 - para 2.

The following plans are now sent herewith. Error is regretted.

853/1-3	1018/51	S/5	Nathania Camp 1-4	LV/1/7(288)
1609/1-2	" /298	S/41	Tulkarm Camp 23	LV/1/7(289)
961/1-4	" /68	L/12	Wadi Sarar Amm. Dumps.	LV/1/7(230)

(Sgd.) ?
for Lt.-Colonel,
A.D.Hirings.

RC.

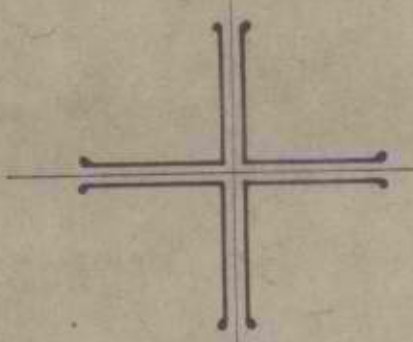

T U L K A R M

B L O C K 8121

B L O C K 8122

B L O C K 7876

ORANGES AND APPLES

B L O C K 7879

B L O C K 7878

A L A N S U W A

BLOCK No: PARCEL No: AREA IN MDNM:

7876	1 Part of	22 350
	2 Part of	33 570
	3 Part of	28 470
	4 Road (P.O.)	0 392
7878	1 P.O.	49 307
	5 Part of	28 300
	7 Part of	30 110
	10 Part of	52 505
	6 Road	1 338
7879	1 Road (P.O.)	1 001
	18 Road (P.O.)	0 952
	21 Part of	3 800
	22 Part of	1 440
	23 Part of	3 620
	24 Part of	3 820
	25 Part of	5 720
	26 Part of	3 585
	27 Part of	3 408
	28 Part of	3 814
	29 Part of	4 725
	30 Part of	4 524
	31 Part of	4 208
	32 Part of	5 335
	36 P.O.	100 114
	37	250 012
	38	130 418
8121	10 Part of	24 000
	11 Part of	20 480
	12 Part of	20 840
	13 Part of	1 870
	15 Part of	67 070
8122	2 Part of	131 150
	3	221 220
	4	221 220
GRAND TOTAL		1756 948

AREA OF PARCELS 1752 265 a.Dnm.
AREA OF ROADS 4083 a.Dnm.

--- BOUNDARY OF CAMP


SCALE 1:2500

CAMP NO. 23

FILE NO. 35646
V. SER. NO. 30/41
DIED ON 9.4.42

HIRING NO.
1310
1609

ATTACHED TO D.D. NO.
DRAWN BY J.L. LAMIA
JERUSALEM 12.4.42

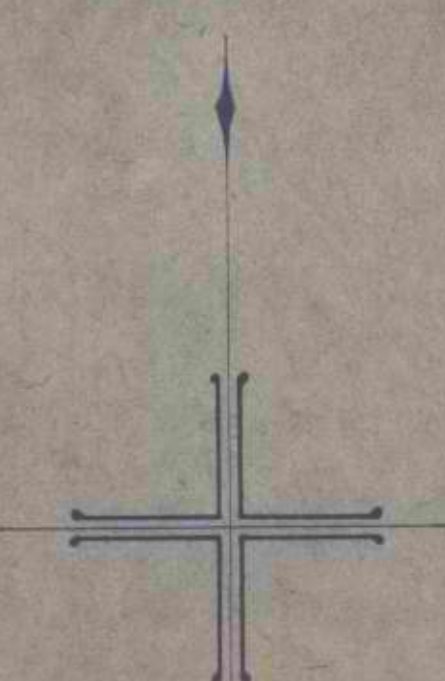

T U L K A R M

B L O C K 8121

B L O C K 8122

B L O C K 7876

ORANGES AND APPLES

B L O C K 7879

B L O C K 7878

A L A N S U W A

R O A D
A N G E R

BLOCK No:	PARCEL No:	AREA IN MDMA:
7876	1 Part of	22.350
	2 Part of	33.570
	3 Part of	28.470
	4 Road (R.O.)	0.392
7878	1 p.c.	49.307
	5 Part of	28.300
	7 Part of	200.110
	10 Part of	52.595
7879	6 Road	1.438
	1 Road (R.O.)	1.901
	18 Road (R.O.)	0.052
	21 Part of	3.660
8121	22 Part of	1.440
	23 Part of	3.620
	24 Part of	3.820
	25 Part of	3.720
	26 Part of	3.585
	27 Part of	3.468
	28 Part of	3.814
	29 Part of	4.725
	30 Part of	4.524
	31 Part of	4.268
	32 Part of	5.335
	36 P.O.	100.114
	37	256.012
	38	130.418
8122	10 Part of	24.000
	11 Part of	20.480
	12 Part of	20.840
	13 Part of	1.870
8122	15 Part of	67.070
	2 Part of	131.150
	3	221.220
	4	221.220
GRAND TOTAL		1756.948

AREA OF PARCELS 1752.265 M.DMA.
AREA OF ROADS 4683 M.DMA.

Boundary of Camp
Hiring 1609/2
Area of Parcels = 559.038
Roads = 1.160
Total = 560.998

Ext added by me
18/1/10

C A M P N O . 2 3

FILE NO. 35648
SERIAL NO. 21/41
DRAWN ON 12.12.10
APPROVED ON 9.4.12
HIRING NO. 1609

ATTACHED TO D.D. HIRING NO. 1609
DRAWN BY L.A.W.
JERUSALEM 12.4.12

LV/147(288).

DEPARTMENT OF LAND SETTLEMENT,
JERUSALEM.

S E C R E T

Camp 1-4, Nathanya.
Hirings Nos.858/1-3.

My Spot Valuation of the site (excluding buildings and trees) shown on the plan enclosed with A.D. Hirings letter No.168/Hgs. dated 14.9.45 comprising an area of 1481.556 dunums (excluding roads) at the times of occupation, that is 14.9.36 onwards, 1.10.42, 15.12.43 (no account being taken of any appreciation in the value thereof due to the emergency) is *see*

secret file LV/S/3

Dated the 18th of September, 1945.

A.G.K.
A.G. KHOURI
ASST.LAND VALUER.

RC.

see LV/147/288

C O P Y

SUBJECT:- 'Spot' Valuations.

HIRINGS SERVICE
HQ PALESTINE
Tel. 4651-Ext. 190
168/Hgs.
14 Sep 45.

Director of Land Settlement,
Jerusalem.

1. Will you please supply 'spot' valuations of the following sites:-

Plans are sent herewith.

Section 1. Very urgently required as Installation Valuation Returns are to be submitted during September.

<u>Hg.No.</u>	<u>WD Inst.No.</u>	<u>Plan No.</u>	<u>Name of Site</u>	<u>File No.</u>
504/1	1019/5	H/172	Haifa Harbour Estate	LV/1/7(217)
1528/1	1018/272	H/64	H.A.A. Site 'L', Neuhardhof	LV/1/7(231)
1598/1	" /279	H/96	H.A.A. Site 'Z', Khirbet Damun	LV/1/7(232)
1274/5	1019/16	H/212/1	S/L Motzkin 'B'	LV/1/7(233)
1481/1	1018/183	N/93	Kefar Inan Camp	LV/1/7(234)
1564/1-2	" /87	H/62	Vehicle Park Misliya	LV/1/7(235)
1274/38	1019/23	H/145	S/L No. 21 French Carmel	LV/1/7(236)
1157/1	1018/154	L/35	Bashit Camp	LV/1/7(237)

P.S. Ref. your LV/1(7) of 3 Sep 45 - para 2.

The following plans are now sent herewith. Error is regretted.

853/1-3	1018/51	S/5	Nathania Camp 1-4	LV/1/7(288)
1609/1-2	" /298	S/41	Tulkarm Camp 23	LV/1/7(289)
961/1-4	" /68	L/12	Wadi Sarar Amm. Dumps.	LV/1/7(239)

(Sgd.) ?
for Lt.-Colonel,
A.D. Hirings.

RC.

DISTRICT : SAMARIA
SUB-DISTRICT : TULKARM
VILLAGES : NATANYA, GHABET KAFR SUR
BLOCKS : 7931, 7932, 7933, 8244, 8245, 8246
8247, 8248, 8250, 8251, 8252, 8254
8275,

NET AREA = 1481,556 M.DNM
ROADS = 141,704 "
TOTAL = 1623,260 "



SURVEYED BY: J. LAY
DRAWN BY: J. LAY
Date: 30.5.44
HQS PLAN CHECKED BY:
Date: 31.5.44
W.D. JUSTIN, PLAN CHECKED BY:
Date: 1.6.44

NATANYA CAMPS NOS. 1, 2, 3 & 4

FILE NO.	OCCUPIED on	SURVEYED on	HIRING NO.	SURV. SER. NO.
P/1018/51	Various Dates from 14.9.36		853/1	JM/5/1
	1.10.42		853/2	JM/5/2
	15.12.43	19.1.44	853/3	JM/5/3

SCHEDULE OF AREAS 853/1

GHABET KAFR SUR
BLOCK 7931

BLOCK 8247

BLOCK 8248

BLOCK 8251

BLOCK 8275

PARCEL NO.	AREA IN M.D.M.	PARCEL NO.	AREA IN M.D.M.	PARCEL NO.	AREA IN M.D.M.	PARCEL NO.	AREA IN M.D.M.	PARCEL NO.	AREA IN M.D.M.
PARCELS	ROADS	PARCELS	ROADS	PARCELS	ROADS	PARCELS	ROADS	PARCELS	ROADS
1	1.707	19	0.856	81	0.574	38	0.931	58	0.500
2	50.000	20	0.669	82	0.553	39	0.900	59	0.500
3	71.590	21	0.910	83	0.457	40	0.913	60	0.955
		22	0.938	84	0.423	41	0.850	61	0.812
		23	0.752	85	0.440	42	1.099	62	0.500
		24	0.800	86	0.694	43	1.092	63	0.500
		25	0.800	87	1.014	44	1.075	64	0.500
		26	0.801	88	0.853	45	1.018	65	0.500
		27	0.983	89	0.720	46	1.029	66	0.498
		28	1.005	90	0.720	47	1.022	67	0.593
		29	1.020	91	0.720	48	1.013	68	0.498
		30	1.172	92	0.723	49	0.909	69	0.502
		31	1.205	93	0.649	50	16.090	70	0.500
		32	0.602	94	0.768	51	0.632	71	0.500
		33	0.749	95	0.775	52	0.573	72	0.500
		34	0.704	96	0.778	53	0.709	73	0.500
		35	0.595	97	0.756	54	0.719	74	0.500
		36	0.680	98	0.733	55	0.611	75	0.500
		37	0.670	99	0.710	56	0.611	76	0.500
		38	0.693	100	0.644	57	0.611	77	0.500
		39	0.864	101	0.620	58	0.611	78	0.500
		40	1.051	102	0.507	59	0.611	79	0.500
		41	0.646	103	0.976	60	0.611	80	0.750
		42	0.602	104	0.705	61	0.611	81	0.498
		43	0.658	105	0.158	62	0.611	82	0.598
		44	0.726	106	1.152	63	0.680	83	0.497
		45	1.209	107	1.009	64	0.414	84	0.499
		46	0.506	108	0.872	65	0.619	85	0.500
		47	0.605	109	0.733	66	0.612	86	0.500
		48	0.726	110	0.592	67	0.612	87	0.500
		49	0.393	111	0.449	68	0.612	88	0.500
		50	0.779	112	0.582	69	0.578	89	0.498
		51	0.540	113	0.716	70	0.578	90	0.510
		52	0.649	114	0.592	71	0.578	91	0.919
		53	0.894	115	0.502	72	0.597	92	11.299
		54	0.773	116	1.029	73	0.616		
		55	0.741	117	0.854	74	0.812		
		56	0.611	118	1.036	75	0.450		
		57	0.947	119	0.670	76	0.487		
		58	0.698	120	0.576	77	0.569		
		59	0.730	121	1.218	78	0.488		
		60	1.159	122	1.147	79	0.499		
		61	1.129	123	1.149	80	0.510		
		62	0.727	124	0.612	81	0.442		
		63	0.884			82	0.439		
		64	0.908			83	0.484		
		65	4.971			84	5.064		
		66	0.854						
		67	1.018						
		68	0.985						
		69	0.878						
		70	0.874						
		71	0.854						
		72	0.856						
		73	0.856						
		74	0.856						
		75	0.938						
		76	12.258						
		77	0.782						
		78	0.567						
		79	0.645						
		80	0.477						
		81	0.440						
		82	0.542						
		83	0.565						
		84	0.677						
		85	0.674						
		86	0.516						
		87	0.461						
		88	0.444						
		89	0.544						
		90	0.745						
		91	0.447						
		92	0.334						
		93	0.416						

Total: 1455.806 141.704
AREA TO BE
LEASED :- 1455.806
ROADS :- 141.704
TOTAL AREA
OCCUPIED :- 1597.510

853/2

BLOCK 8244
2 pc 10.000

AREA TO BE
LEASED :- 10.000

853/3

BLOCK 8245
15 pc 15.750

AREA TO BE
LEASED :- 15.750

DISTRICT
SUB-DIVISION
VILLAGE
BLOCKS

NET AREA
ROADS
TOTAL



SURVEYED BY: J
DRAWN BY: S.
Date: 30.5.44
HQS PLAN CHECKED
Date: 31.5.44
W.D. INSTRNS. PLAN
Date: 1.8.44

SCHEDULE OF AREAS 853/1									
BLOCK 7931		BLOCK 8247		BLOCK 8248		BLOCK 8251		BLOCK 8275	
PARCEL NO.	AREA IN M.D.M.	PARCEL NO.	AREA IN M.D.M.	PARCEL NO.	AREA IN M.D.M.	PARCEL NO.	AREA IN M.D.M.	PARCEL NO.	AREA IN M.D.M.
1	1.707	17	0.856	81	0.574	38	0.931	58	0.500
2	30.000	20	0.669	82	0.453	39	0.440	59	0.500
3	71.590	21	0.910	83	0.457	40	0.913	60	0.458
BLOCK 7932									
4	54.493	22	0.938	84	0.423	41	0.880	61	0.500
5	57.400	23	0.780	85	0.474	42	0.499	62	0.500
6	4.338	24	0.800	86	0.440	43	0.492	63	0.500
7	1.284	25	0.800	87	1.014	44	1.075	64	0.500
BLOCK 7933									
8	17.300	26	0.801	88	0.403	45	1.018	65	0.500
BLOCK 8244									
9	15.136	27	0.983	89	0.720	46	1.029	66	0.498
10	10.374	28	1.005	90	0.720	47	1.022	67	0.583
11	9.578	29	1.172	91	1.010	48	1.013	68	0.500
NATANYA									
BLOCK 8245									
12	11.770	30	1.205	92	0.723	49	1.009	69	0.502
13	11.738	31	1.205	93	0.649	50	1.090	70	0.500
14	3.565	32	0.602	94	0.768	51	0.622	71	0.500
15	9.123	33	0.744	95	0.778	52	0.573	72	0.500
16	9.340	34	0.704	96	0.778	53	0.709	73	0.500
17	15.912	35	0.935	97	0.785	54	0.719	74	0.500
18	16.534	36	0.680	98	0.611	55	0.785	75	0.500
19	3.286	37	0.670	99	0.710	56	0.611	76	0.500
20	9.287	38	0.693	100	0.644	57	0.611	77	0.500
21	3.257	39	0.864	101	0.660	58	0.611	78	0.500
22	4.184	40	1.051	102	0.507	59	0.611	79	0.500
23	18.888	41	0.646	103	0.970	60	0.611	80	0.750
24	9.130	42	0.602	104	0.705	61	0.611	81	0.448
25	1.100	43	0.658	105	0.158	62	0.611	82	0.558
26	3.344	44	0.716	106	1.182	63	0.680	83	0.497
27	3.257	45	0.716	107	1.209	64	0.414	84	0.497
28	13.856	46	0.500	108	0.973	65	0.419	85	0.500
29	9.321	47	0.605	109	0.793	66	0.412	86	0.500
30	18.750	48	0.726	110	0.595	67	0.412	87	0.500
31	4.090	49	0.393	111	0.449	68	0.412	88	0.500
BLOCK 8246									
1	0.429	50	0.779	112	0.582	69	0.578	89	0.498
2	0.321	51	0.540	113	0.716	70	0.578	90	0.510
3	0.779	52	0.547	114	0.592	71	0.592	91	0.510
4	0.520	53	0.894	115	0.502	72	0.597	92	11.293
5	0.520	54	0.773	116	1.025	73	0.616	Total 1455.806 141.704	
6	0.520	55	0.741	117	0.884	74	0.616	AREA TO BE LEASED - 1455.806	
7	0.520	56	0.611	118	0.884	75	0.480	ROADS - 141.704	
8	0.520	57	0.347	119	0.270	76	0.487	TOTAL AREA OCCUPIED - 1597.510	
